


- GEOMETRIC LEGEND**
- PROPOSED _____
- EXISTING _____
- LEGEND OF UNDERGROUND
AND OVERHEAD UTILITIES**
- | | |
|--------------|-------------|
| AERIAL CABLE | — A — A — |
| ELECTRIC | — E — E — |
| TELEPHONE | — T — T — |
| GAS | — G — G — |
| SEWER | — S — S — |
| WATER | — W — W — |
| CABLE TV | — TV — TV — |

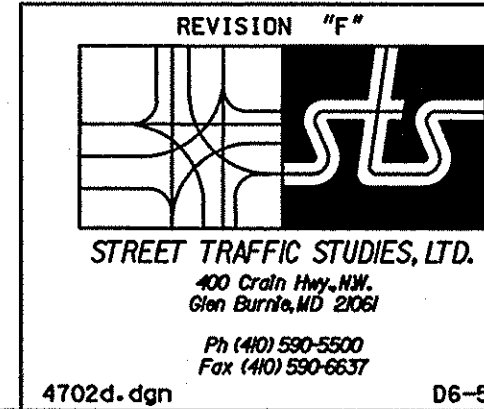

APPROVALS	
TEAM LEADER	
ASST. DIV. CHIEF	
DIVISION CHIEF	
OFFICE DIRECTOR	

REVISONS				11-16-0	
INSTALL MICRO-PROBES DUE TO GEOMETRIC CHANGES					
SHA NO.: TA4265187					
JWA	JWA		JWA		9-28-0
				4-00	
INSTALL SIDE STREET SPLIT PHASE					
SHA NO.: OT19991					
DBD	DAZ	BRK	TH		
				10-13-9	
ASBUILT					
SHA NO.:					
RRZ					

TS NO. 348F	DRAWING NO. OF	SHEET NO. 39 OF 55
-------------	----------------	--------------------

PLOTTED: \$DATETIME\$
FILE: \$FILE\$